




**Friedman  
Brueggemeyer**  
924 Carleton  
Street  
Berkeley, CA  
94710  
510.848.3390

**F.E. Forbes**  
1795 Solano Ave.  
Berkeley, CA

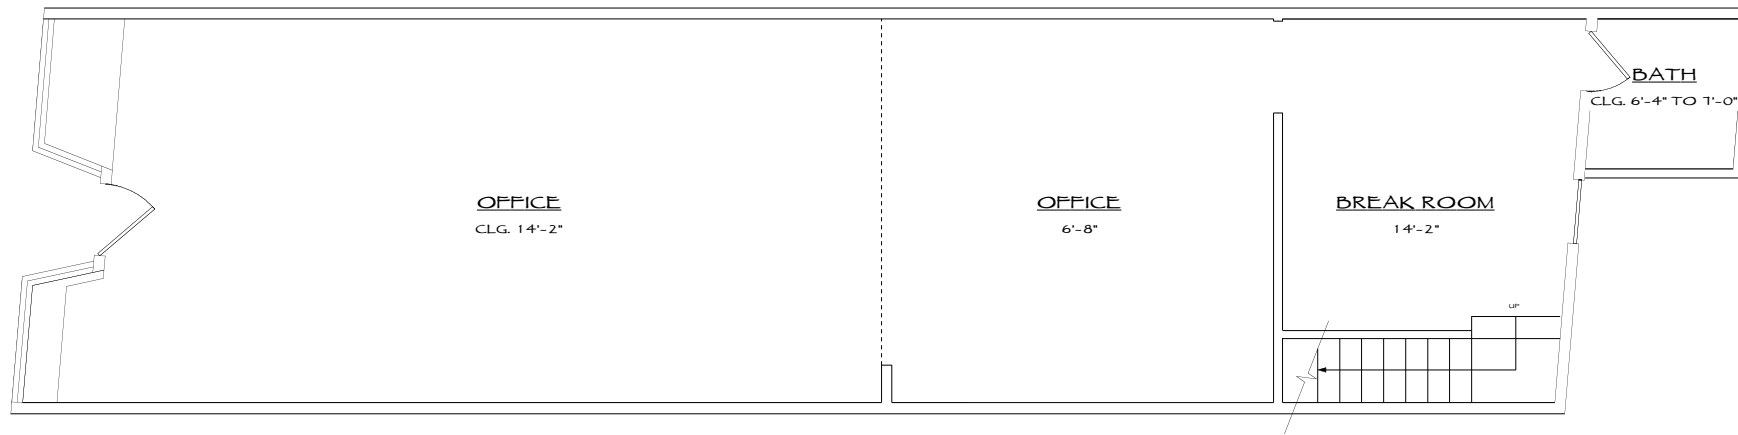

AS-BUILT PLAN

**FLOOR  
PLAN**

**REVISIONS**

No.	Date	By

Date: 09/10/03

Scale: AS NOTED

Drawn By: CL

**A-1**